THE KLAMATH TRIBES

INVITATION

FOR

BID

ADDENDUM #2

ADMINISTRATION BUILDING ROOF REPAIR

IFB 04-26

SCOPE OF WORK CLARIFICATIONS/DESIGNS

CLOSES: 3:00 PM MARCH 23, 2026

The Klamath Tribes is issuing Addendum #1 to address questions regarding the scope of work listed for IFB 04-26 and issue designs from original building construction.

---

1. **Task Clarification:** Warranty should be between 20-50 years.

2. **Task Clarification:** Insulation with a value of R25-R38 to be installed for better energy efficiency.

3. **Mold:** The attic area has been tested for mold years ago, mold was not detected. The Klamath Tribes would be willing to submit to more testing.

4. **Attachments:** Available building drawings by Robert J Bogatay Construction and James D. Matteson Architect is attached for reference. The original design plans for the roof are unable to be found.

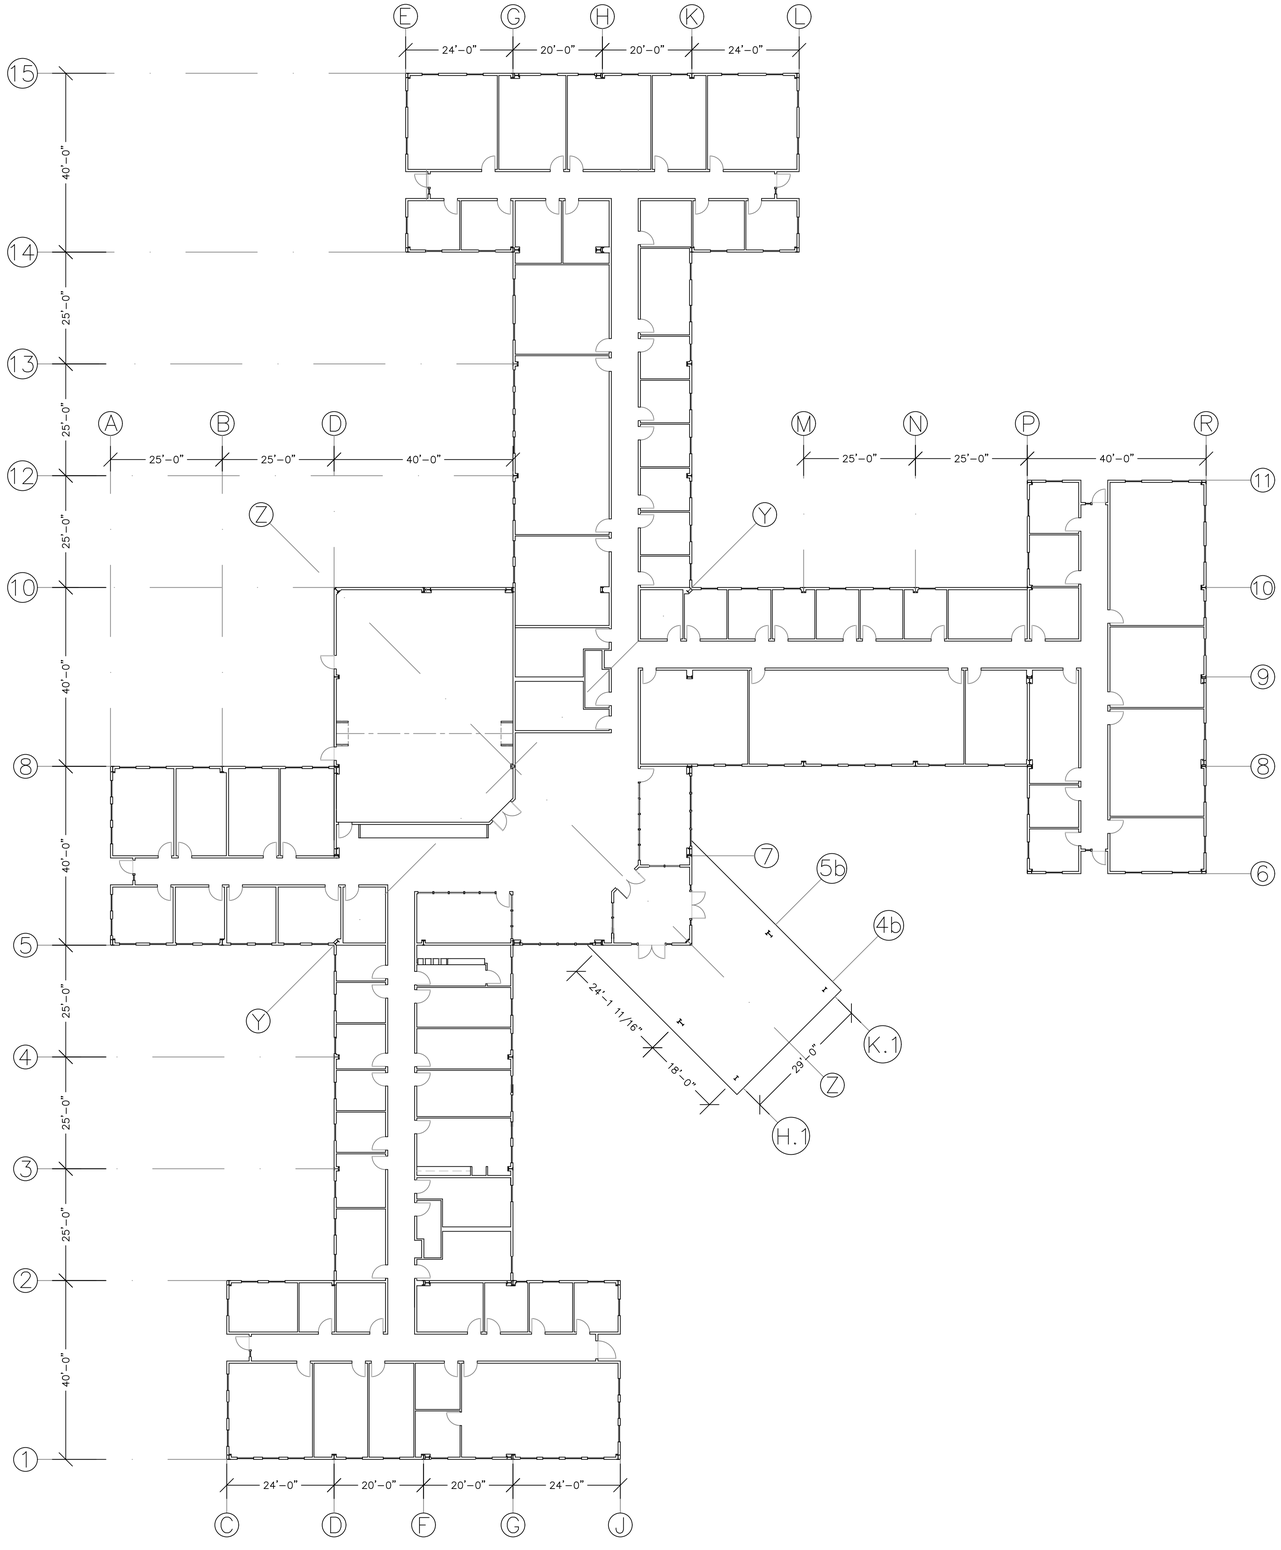

1 GENERAL LAYOUT
Scale: 1/16" = 1'-0"

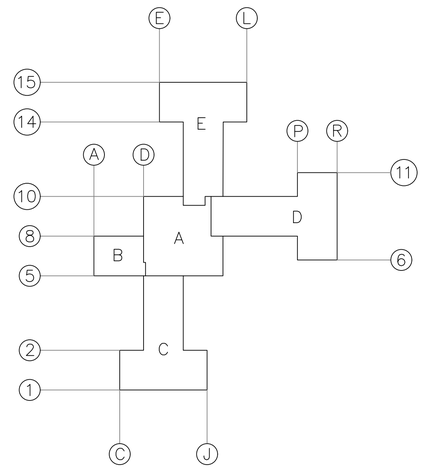

KEY PLAN PER ARCHITECT

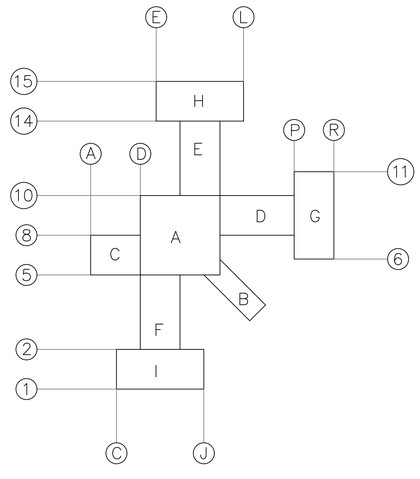

KEY PLAN PER METALLIC BLDG. CO.

Precision Structural Engineering, Inc.
4810 B Shasta Way
Klamath Falls, Oregon 97603
Phone: (541) 850-6300
Fax: (541) 850-6233
www.structure1.com

Project:

KLAMATH TRIBES CENTRALIZED SOCIAL SERVICES AND ADMINISTRATION BUILDING

CHILOQUIN, OREGON

Architect:

JAMES MATTESON

Contractor:

BOGATAY CONSTRUCTION

Stamp:

PRELIMINARY NOT FOR BID OR CONSTRUCTION

REVISIONS:

MARK:	DATE:	DESCRIPTION / BY:

DRAWN BY: RYAN FARNSWORTH
DESIGNED BY: AB
CHECKED BY: NT
ISSUE DATE: 9-20-2001 "AS BUILT"
PROJECT NUMBER: 20-202

SHEET TITLE: LAYOUT AND GRID LINES

PAGE NO: S1 OF 8

STRUCTURAL GENERAL NOTES • APPLICABLE TO ALL CONSTRUCTION UNLESS OTHERWISE NOTED ON THE PLANS

A. GENERAL REQUIREMENT:
1. Furnish all labor, materials, and equipment necessary to complete the work shown or inferred by these drawings.
2. Where construction details are not shown or noted for any part of the work, such details shall be the same as for similar work shown on the drawings.
3. Notes and details on the drawings take precedence over the general notes and typical details in case of conflict.
4. Pipes, ducts, sleeves, chases, etc. shall not be placed in slabs, beams, or walls unless specifically shown or noted nor shall any structural member be cut for pipe, ducts, etc., unless specifically shown. Obtain prior written approval for installation of any additional holes, ducts, etc.
5. The contract drawings and specifications represent the finished structure and do not indicate methods, procedures or sequence of construction. Take necessary precautions to maintain and insure the integrity of the structure during construction. The design stresses shall not be exceeded during construction based on the age of each element . Neither the owner nor Architect/Engineer will enforce safety measure regulations. Contractor shall design, construct and maintain all safety devices, including shoring and bracing, and shall be solely responsible for conforming to all local, state and federal safety and health standards, laws and regulations.
6. Obtain prior written approval for any changes to the drawings.
7. The contractor shall review and compare the structural drawings with all other Construction Documents, such as Architectural, Mechanical and Electrical drawings, specifications, etc.. The contractor shall verify dimensions, elevations and all information. Report, in writing, any inconsistencies, errors, or omissions to the Architect/Engineer of record before proceeding with the work.
8. See Architectural, Mechanical, Electrical and other drawings for embedded items.
9. Shop drawings:
   a) Shop drawings shall be submitted to the Architect/Engineer prior to fabrication and construction regarding all structural items including:
   —Concrete and masonry reinforcement, drawings shall conform to ACI 315 and ACI 318.

B. CODE AND LOADS:
1. All design, material, and construction work for this project shall conform to the OSSC, 1998 Edition.
2. Footings are designed to support the reactions provided to PSE by Metalic Building Company, sheet 4, dated January 3, 2001.

C. TESTING:
The owner/contractor shall retain an independent testing laboratory to test the quality of:
a) Soil or fill material supporting footings and slab—on—grade.
b) Concrete.
c) Grout and mortar for masonry.
d) All other material used in this project as required by the Engineer.
e) A copy of test results shall be sent to the Engineer of Record.

D. INSPECTION:
The owner shall employ one or more qualified Inspectors to provide inspections during construction in according with section 1701 of State of Oregon Structural Specialty Code. The Inspector shall be certified by the building official to perform the type of inspection specified. Inspection shall be provided for:
1. Foundation excavation.
2. Reinforcement placement, prior to closing the forms and delivery of concrete.
3. Concrete placement.
4. Bolts installed in concrete and masonry, prior to and during the placement of concrete around bolts.
5. Structural masonry, verification of compliance for f'm (UBC 2105.3), at the start of laying units, after the placement of reinforcing steel, grout space prior to each grouting operation, and during all grouting operation.
6. Epoxy filled anchor bolts.
7. Structural Steel.
8. Field welding.
9. High—strength bolting.
10. During preparation and taking of test specimens.
11. See other sections of these notes for more required inspections.

Note: All discrepancies shall be brought to the immediate attention of the contractor for correction; then if not corrected, to the building official and to the Engineer in writing. The inspector shall furnish an inspection report to the building official and to the Engineer/Architect of Record.

E. FOUNDATION
1. A foundation investigation and report project no. 02—1854—01 was prepared by The Galli Group, 1351 Highland Avenue, Grants Pass, OR 97526. The contractor shall read and follow the recommendations in this report. Contractor shall keep a copy of this report on site at all times during construction.
2. If the stated bearing capacity, as determined by the geotechnical engineer, is not encountered, the contractor shall notify the Engineer.
3. Footing shall bear on natural soil or compacted engineering fill capable of supporting the required bearing capacity.
4. Soft soil shall be removed and replaced with competent material approved by the Engineer.
5. Natural soil or engineering fill shall be proofrolled and/or compacted to minimum of 95% under slab—on—grade and to minimum of 98% under footing of their maximum dry density, as determined by ASTM Test Method D—698 (standard Proctor).
6. Excavation shall be properly backfilled. Back fill for walls shall be pervious material acceptable to the Geotechnical Engineer. Do not place back fill behind walls before they have attained their design strength. Shore and protect walls from lateral loads until the supporting members are in place and have developed specified strength.
7. Use light weight equipment to compact the soil within 2 feet around foundation wall/grade beam.
8. Footing shall be stepped as required to maintain 24 inches minimum, below finished grade.
9. Provide 4 inch diam. perforated drain pipe below the top of the footing. See additional requirements per the Foundation Investigation Report.
10. Roof and area drainage shall be directed away from the foundation.
11. Reference the specifications for additional requirements.

F. CONCRETE:
1. All concrete work shall conform to the American Concrete Institute's Standard Building Code Requirements for Structural Concrete, ACI 318, the edition specified in OSSC. Place concrete in accordance with ACI 301.
2. Materials shall comply with:
   a) Cement, ASTM C150 Type I or II.
   b) Aggregate, ASTM C33.
   c) Water, Potable.e
   d) Anchor bolts ASTM A—307 headed machine bolts.
3. Concrete shall develop 28—days minimum compressive strengths of 3500 PSI.
4. All exposed exterior concrete shall contain the proper admixtures to obtain 5% to 7% Air Entrainment.
5. Concrete mixes shall be designed and tested by a testing laboratory. The mix design shall establish the quantity of all ingredients including water to produce concrete of the required strengths, slump and durability.
6. Reinforcing Steel:
   a) All reinforcing steel shall be ASTM A615 Grade 60.
   b) Bars marked continuous and all vertical steel shall be lapped 48 bar diameters at splices UON on the drawings.
   c) Vertical bars shall be doweled to supporting members with the same size and spacing of reinforcement shown in the drawing or general notes.
   d) All reinforcing in grade beams shall be continuous.
   e) Splices shall be 48 bar diameters or 30 inches whichever is greater UON.
   f) Clear distance between parallel reinforcement in a layer shall not be less than 1—1/2 times the diameter of the reinforcement, or 1—1/3 times maximum size aggregate, nor less than 1—1/2".
   g) Tack welding, welding, heating or cutting of bars is not permitted UON.
   h) All reinforcing bars shall be in the correct place, tied and secured prior to concrete placement. Use chairs, spacers and sand plates as required.
7. Execution:
   a) All concrete is reinforced concrete unless specifically called out as "Unreinforced". Reinforce all concrete not otherwise shown with same steel as in similar sections or areas.
   b) At all openings in concrete walls and slabs, add 2—# 5 bars (opening dimension plus 60 bar diameters long) at each of the four sides and 2—#5 X 5'—0" long diagonally at each of the four corners.
8. Standard concrete cover of bars unless otherwise noted shall be:
   a) Where earth formed: 3 inches.
   b) Board formed then permanently exposed to earth or weather: 2 inches.
   c) Slabs not exposed to earth or weather: 1 inch.
   d) Beams and columns not exposed to earth or weather: 1—1/2 inches.
   e) Others: 2 inches.
9. Slump shall not be more than 4 inches.
10. Water/Cement ratio shall not exceed 0.45.
11. All concrete shall be consolidated with mechanical vibrators.
12. The unit of pour for foundation walls and footings shall not exceed 80 linear feet in any one direction. Construction joints shall be doweled and keyed.
13. Construction joints in beams, slabs, and grade beams shall occur at middle one third of the span. Provide (1) 2X4 inch horizontal key per foot of depth at construction joint. Location of joints to be reviewed by the Engineer. Wait 48 hours between placements.
14. Location of control, expansion and construction joints shall be approved by the Architect/Engineer.
15. Coordinate concrete work with architectural drawings and specifications for any architectural finished concrete, recessed area, embedded items, or special control joint patterns.
16. No Aluminum or galvanized steel items shall be embedded in concrete.
17. All exposed edges not in contact with masonry mortar shall be beveled 3/4 inch.
18. All concrete work shall be cured by saturated cover and maintained above 50 degrees Fahrenheit for at least seven days or by other method according to the Standard Practice for Curing Concrete, ACI 308, ACI 318 and as approved by the Engineer.
19. When air temperature is above 80 degrees Fahrenheit, Hot Weather Concreting, ACI 305R shall apply. When the average air temperature is below 40 degree Fahrenheit, Cold Weather Concreting, ACI 306R shall apply.
20. Reference the specifications for additional requirements.

G. SLAB—ON—GRADE:
1. See "Concrete" and "Foundation notes above for additional requirements.
2. Concrete mix:
   a) Slump shall not be more than 3 inches.
   b) Nominal maximum size of aggregate shall be 1 inch.
3. Prior to placing concrete, prepare and compact the sub—grade and sub—base per contract document.
4. If vapor barrier is not used, dampen the sub—grade/sub—base by spraying water before concreting.
5. Finishing Slabs:
   a) Do not directly apply water to slab surface or dust with cement.
   b) All methods, techniques and equipment shall be as recommended in ACI 302.1R.
   c) Screeding: Strikeoff to required grade and with surface tolerances indicated. Verify conformance to surface tolerances. Correct deficiencies while concrete is still plastic.
   d) Bull Floating: Immediately following screeding, bull float or darby before bleed water appears to eliminate ridges, fill in voids, and embed coarse aggregate. Recheck and correct surface tolerances.
   e) Do not perform subsequent finishing until excess moisture or bleed water has disappeared and concrete will support either foot pressure with less than 1/4 inch indentation or weight of power floats without damaging flatness.
   f) Final floating: Float to embed coarse aggregate, to eliminate ridges, to compact concrete, to consolidate mortar at surface, and to achieve uniform, sandy texture. Recheck and correct surface tolerances.
   g) Troweling: Trowel immediately following final floating. Apply first troweling with power trowel except in confined areas, and apply subsequent troweilings with hand trowels. Wait between troweilings to allow concrete to harden. Do not overtrowel. Begin final troweling when surface produces a ringing sound as trowel is moved over it. Consolidate concrete surface by final troweling operation. Completed surface shall be free of trowel marks, uniform in texture and appearance, and within surface tolerances specified.
6. Slab surface tolerances:
   a) Achieve flat, level planes except where grades are indicated. Slope uniformly to drains.
   b) Troweled finishes: Achieve level surface plane so that depressions between high spots do not exceed 1/4 inch, using a 10—foot straightedge.
7. Provide sawn floor slab control joint where shown on plans. Where not shown, limit maximum spacing between control joints to 15 feet for indoor slabs, 8 feet for outdoor driveway and 5 feet for sidewalks.
8. Saw cuts shall be made immediately after final finishing without dislodging aggregate.
9. Joint fill for control joint:
   a) Use elastomeric sealant for areas where no vehicle traffic exists.
   b) Use semi—rigid epoxy where vehicle traffic exists.
10. At expansion joint, use premolded fiber joint material, then use joint filler as described above.

H. ANCHOR BOLTS:
Anchor bolts shall be embeded 12" into concrete (pedestals). Use Simpson SET EPOXY per manufacturer recommendations.

I. ABBREVIATIONS:

AB	ANCHOR BOLT	ES	EACH SIDE	MB	MACHINE BOLT	SEP	SEPARATION
ADDL	ADDITIONAL	EW	EACH WAY	MFR	MANUFACTURER	SIM	SIMILAR
ALT	ALTERNATE	EXTG	EXISTING	MIN.	MINIMUM	SN	SHEAR NAIL
APA	AMERICAN PLYWOOD ASSOCIATION	FA	FRAMING ANCHOR	MTL	METAL	SNL	SNOW LOAD
		FEN	FLOOR EDGE NAILING	NO.	NUMBER	SPEC	SPECIFICATION
ARCH	ARCHITECTURAL	FF	FINISHED FLOOR	NS	NEAR SIDE	STD	STANDARD
B	BOTTOM	FN	FIELD/INTERMEDIATE NAILING	NTS	NOT TO SCALE	STGR	STAGGER
BLKG	BLOCKING			OC	ON CENTER	STIFF	STIFFENERS
BN	BOUNDARY NAIL	FS	FAR SIDE	OD	OUTSIDE DIAMETER	T	TOP
BOF	BOTTOM OF FOOTING	FTG	FOOTING	OFDSC	OREGON ONE & TWO FAMILY DWELLING SPECIALTY CODE	TB	TOP & BOTTOM
CJ	CONSTRUCTION JOINT OR CONTROL JOINT	GALV	GALVANIZED			TD	TYPICAL DETAILS
		GC	GENERAL CONTRACTOR	OH	OPPOSITE HAND	TG	TONGUE & GROOVE
CL	CENTER LINE	GIR	GEOTECHNICAL INVESTIGATION REPORT	OSB	ORIENTED STRAND BOARD	THK	THICKNESS/THICK
CLR	CLEAR			OSSC	OREGON STRUCTURAL SPECIALTY CODE	TN	TOENAIL
CONN	CONNECTION	GLB	GLUED LAMINATED BEAM			TOB	TOP OF BEAM
CONT	CONTINUOUS	GR	GRADE	OSV	ON SITE VERIFY	TOF	TOP OF FOOTING
DBL	DOUBLE	HDR	HEADER	OTOB	OUT TO OUT OF BEARING	TOW	TOP OF WALL
DIM	DIMENSION	HGR	HANGER	PERP	PERPENDICULAR	TYP	TYPICAL
DL	DEAD LOAD	HORIZ	HORIZONTAL	PL	PLATE	UBC	UNIFORM BUILDING CODE
DO	DITTO (REPEAT)	HSH	HORIZONTALLY SLOTTED HOLES	PLF	POUND PER LINEAR FOOT	UON	UNLESS OTHERWISE NOTED
DWG	DRAWING	ICBO	INTERNATIONAL CONFERENCE OF BUILDING OFFICIALS	PSE	PRECISION STRUCTURAL ENGINEERING	VERT	VERTICAL
DWL	DOWEL			PT	PRESSURE TREATED	VSH	VERTICAL SLOTTED HOLES
E	EXISTING	ID	INSIDE DIAMETER	PW	PLATE WASHER	WD	WOOD
EA	EACH	INT	INTERIOR	REF	REFERENCE	WEN	WALL EDGE NAILING
EF	EACH FACE	JT	JOINT	REN	ROOF EDGE NAILING	WWF	WELDED WIRE FABRIC
EL	ELEVATION	LDGR	LEDGER	REINF	REINFORCEMENT	W/	WITH
EMBED	EMBEDMENT	LL	LIVE LOAD	RFT	RAFTERS	W/O	WITHOUT
EN	EDGE NAIL	MATL	MATERIAL	SGN	STRUCTURAL GENERAL NOTES		
EOR	ENGINEER OF RECORD	MAX	MAXIMUM				
EQ	EQUAL						

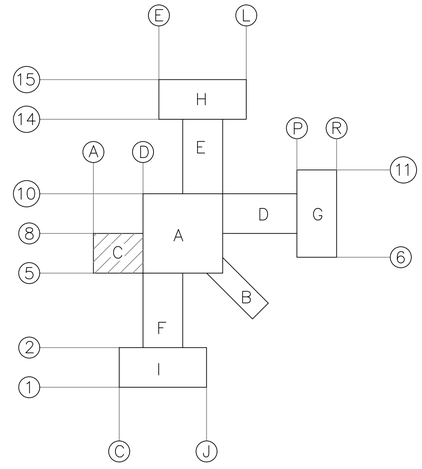

KEY PLAN PER METALLIC BLDG. CO.

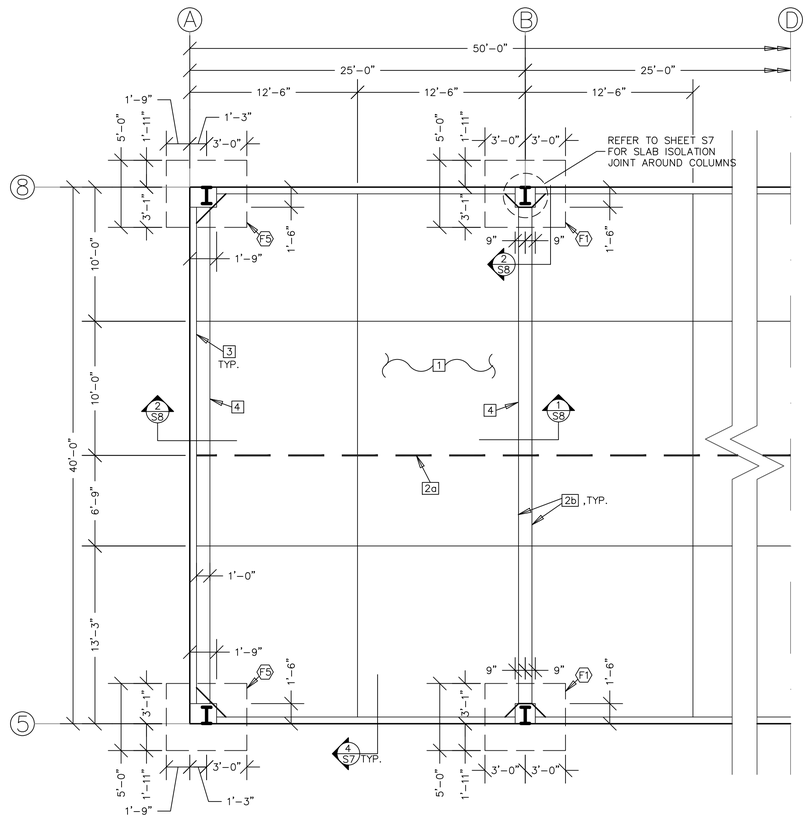

① FOUNDATION PLAN, BUILDING "C"
Scale: 3/16" = 1'—0"

SHEET NOTES:
1. 4" THICK CONCREETE SLAB—ON—GRADE OVER 6" OF FREE DRAINING 3/4" CRUSHED ROCK. CRUSHED ROCK SHALL CONTAIN NO FINES TO PROVIDE A CAPILLARY MOISTURE BREAK. REINFORCE SLAB WITH #4 BARS @ 18" O.C. BOTH WAYS AT SLAB MID—THICKNESS.

2a — — — CONSTRUCTION JOINT PER 9a/S8.

2b ——— CONTROL JOINT PER 9b/S8.

3 GRADE BEAM 7/S8.

4 TIE BEAM

(F) INDICATES FOOTING MARK. REFER TO FOOTING SCHEDULE 4/S8.

Precision Structural Engineering, Inc.
4810 B Shasta Way
Klamath Falls, Oregon 97603
Phone: (541) 850—6300
Fax: (541) 850—6233
www.structure1.com

Project:
KLAMATH TRIBES CENTRALIZED SOCIAL SERVICES AND ADMINISTRATION BUILDING
CHILOQUIN, OREGON

Architect:
JAMES MATTESON

Contractor:
BOGATAY CONSTRUCTION

Stamp:
PRELIMINARY NOT FOR BID OR CONSTRUCTION

REVISIONS:

MARK:	DATE:	DESCRIPTION / BY:

DRAWN BY: RYAN FARNSWORTH
DESIGNED BY: AB
CHECKED BY: NT
ISSUE DATE: 9—20—2001 "AS BUILT"
PROJECT NUMBER: 20—202

SHEET TITLE:
GENERAL STRUCTURAL NOTES & FOUNDATION PLAN, BUILDING "C"

PAGE NO:
S2 OF 8

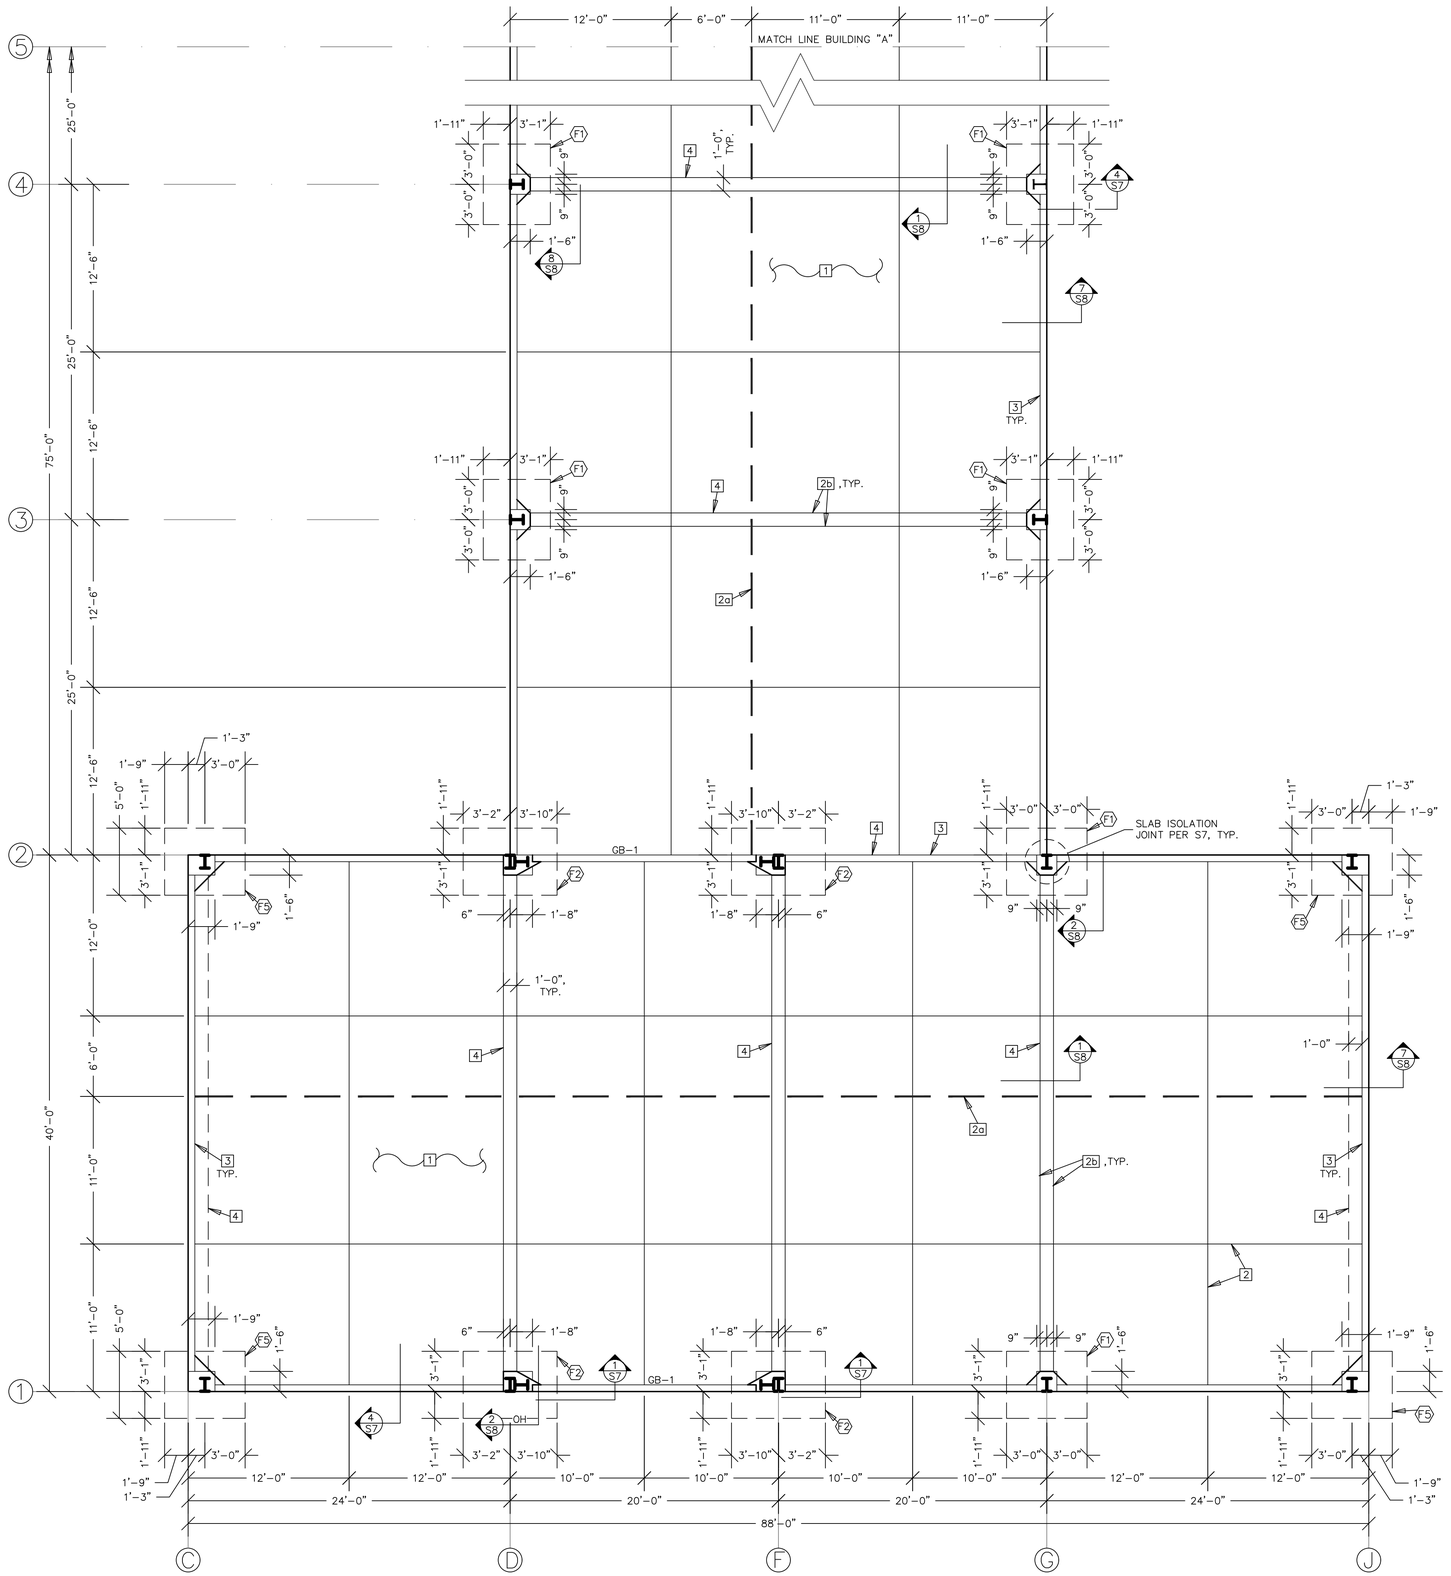

1 FOUNDATION PLAN, BUILDING "I" & "F"
Scale: 3/16" = 1'-0"

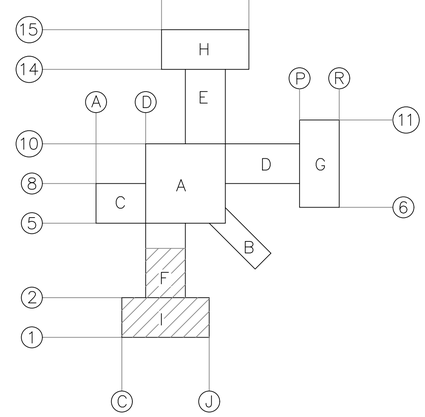

KEY PLAN PER METALLIC BLDG. CO.

SHEET NOTES:

1. 4" THICK CONCREETE SLAB-ON-GRADE OVER 6" OF FREE DRAINING 3/4" CRUSHED ROCK. CRUSHED ROCK SHALL CONTAIN NO FINES TO PROVIDE A CAPILLARY MOISTURE BREAK. REINFORCE SLAB WITH #4 BARS @ 18" O.C. BOTH WAYS AT SLAB MID-THICKNESS.

2a — — — CONSTRUCTION JOINT PER 9a/S8.

2b ——— CONTROL JOINT PER 9b/S8.

3 GRADE BEAM 7/S8.

4 TIE BEAM

(F) INDICATES FOOTING MARK. REFER TO FOOTING SCHEDULE 4/S8.

Precision Structural Engineering, Inc.
4810 B Shasta Way
Klamath Falls, Oregon 97603
Phone: (541) 850-6300
Fax: (541) 850-6233
www.structure1.com

Project:

KLAMATH TRIBES CENTRALIZED SOCIAL SERVICES AND ADMINISTRATION BUILDING

CHILOQUIN, OREGON

Architect:

JAMES MATTESON

Contractor:

BOGATAY CONSTRUCTION

Stamp:

PRELIMINARY NOT FOR BID OR CONSTRUCTION

REVISIONS:

MARK:	DATE:	DESCRIPTION / BY:

DRAWN BY: RYAN FARNSWORTH

DESIGNED BY: AB

CHECKED BY: NT

ISSUE DATE: 9-20-2001 "AS BUILT"

PROJECT NUMBER: 20-202

SHEET TITLE: FOUNDATION PLAN BUILDING "I" & "F"

PAGE NO: S3 OF 8

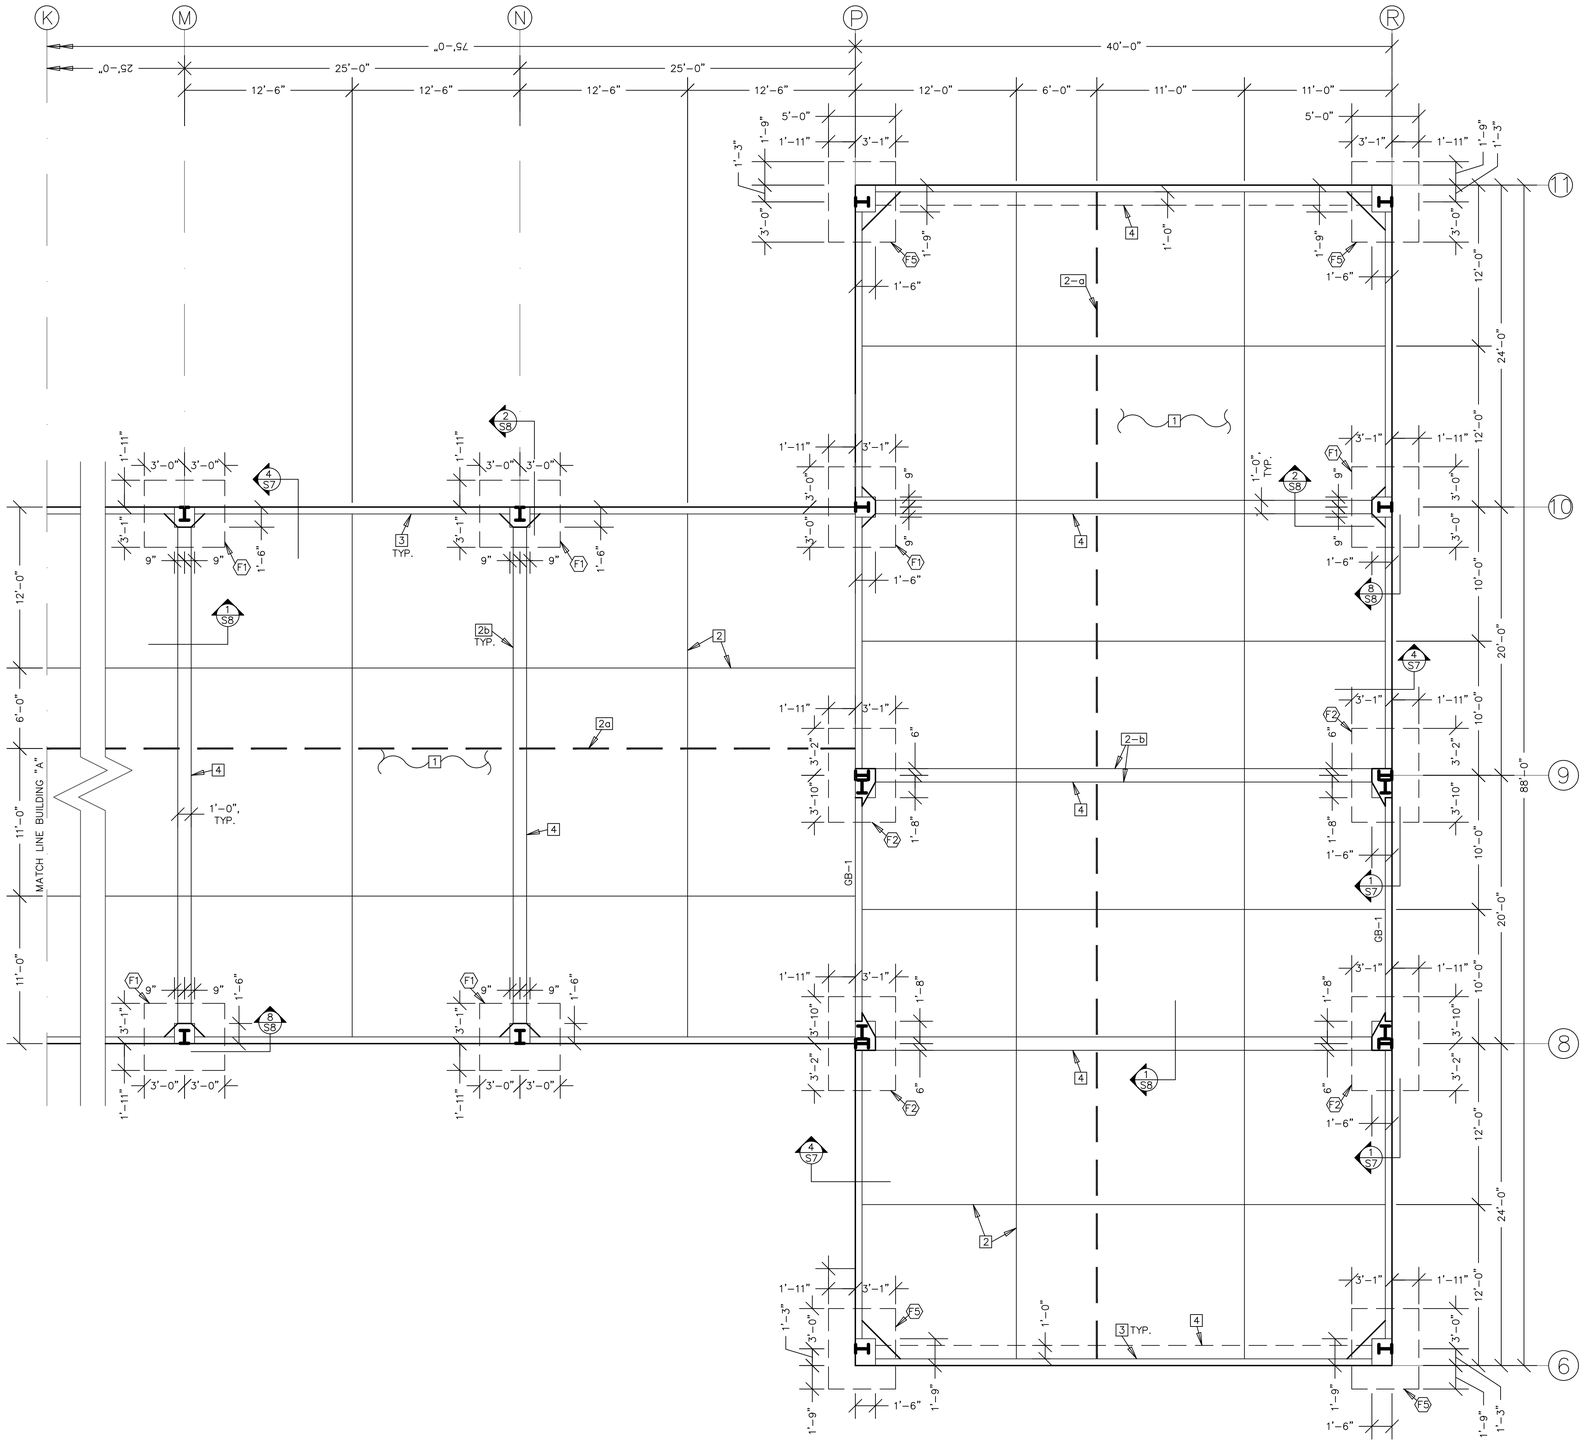

① FOUNDATION PLAN, BUILDING "D" & "G"
Scale: 3/16" = 1'-0"

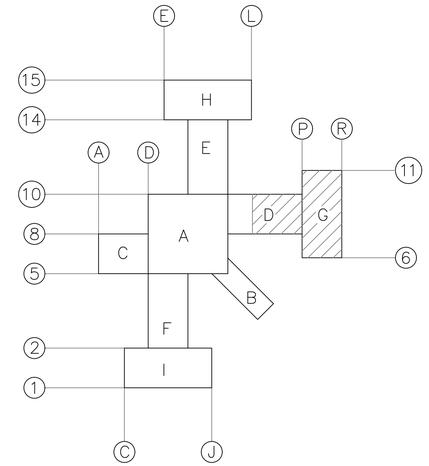

KEY PLAN PER METALLIC BLDG. CO.

SHEET NOTES:

1. 4" THICK CONCREETE SLAB-ON-GRADE OVER 6" OF FREE DRAINING 3/4" CRUSHED ROCK. CRUSHED ROCK SHALL CONTAIN NO FINES TO PROVIDE A CAPILLARY MOISTURE BREAK. REINFORCE SLAB WITH #4 BARS @ 18" O.C. BOTH WAYS AT SLAB MID-THICKNESS.

2a CONSTRUCTION JOINT PER 9a/S8.

2b CONTROL JOINT PER 9b/S8.

3 GRADE BEAM 7/S8.

4 TIE BEAM

(F) INDICATES FOOTING MARK. REFER TO FOOTING SCHEDULE 4/S8.

Precision Structural Engineering, Inc.
4810 B Shasta Way
Klamath Falls, Oregon 97603
Phone: (541) 850-6300
Fax: (541) 850-6233
www.structure1.com

Project:

KLAMATH TRIBES CENTRALIZED SOCIAL SERVICES AND ADMINISTRATION BUILDING

CHILOQUIN, OREGON

Architect:

JAMES MATTESON

Contractor:

BOGATAY CONSTRUCTION

Stamp:

PRELIMINARY NOT FOR BID OR CONSTRUCTION

REVISIONS:

MARK:	DATE:	DESCRIPTION / BY:

DRAWN BY: RYAN FARNSWORTH
DESIGNED BY: AB
CHECKED BY: NT
ISSUE DATE: 9-20-2001 "AS BUILT"
PROJECT NUMBER: 20-202

SHEET TITLE: FOUNDATION PLAN BUILDING "D" & "G"

PAGE NO: S4 OF 8

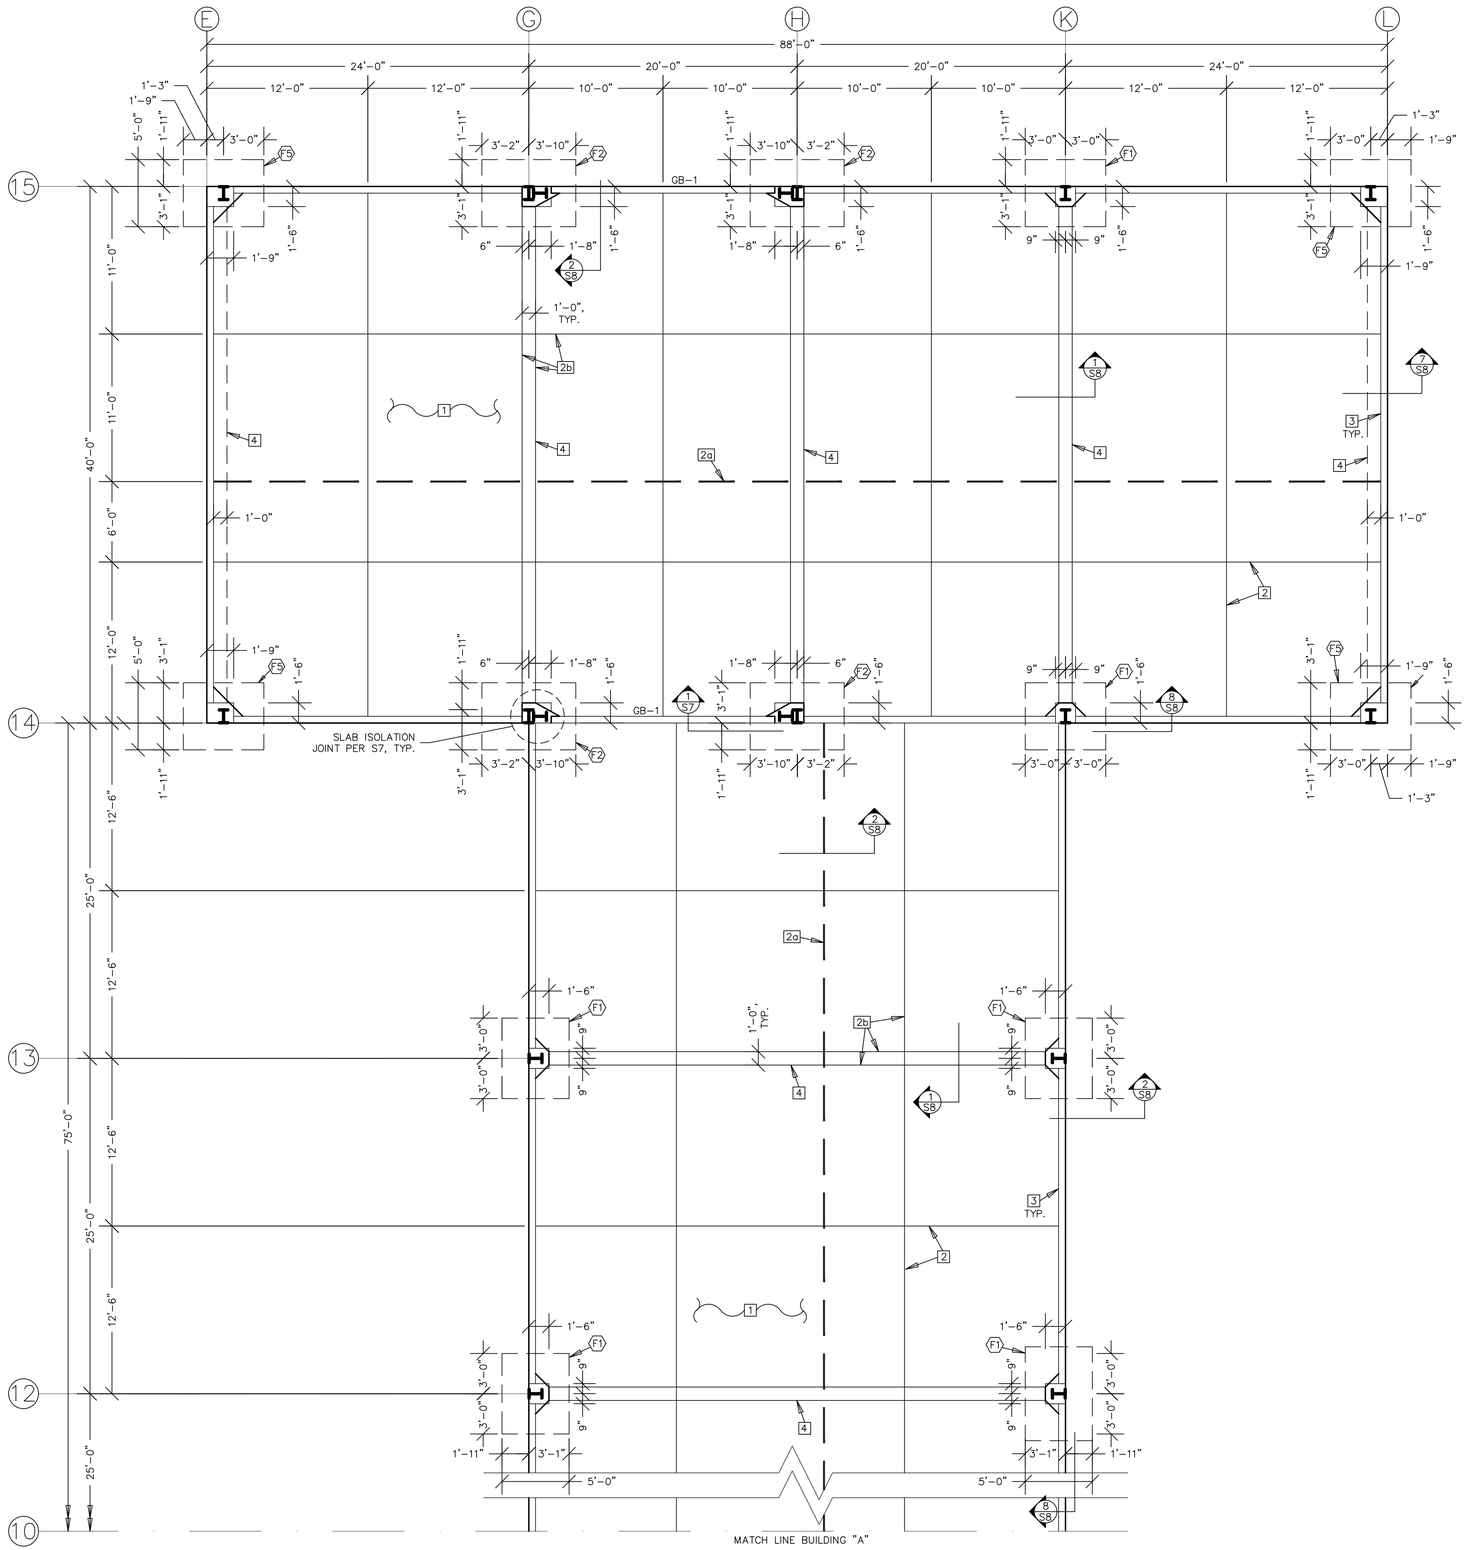

1 FOUNDATION PLAN BUILDING "E" & "H"
Scale: 3/16" = 1'-0"

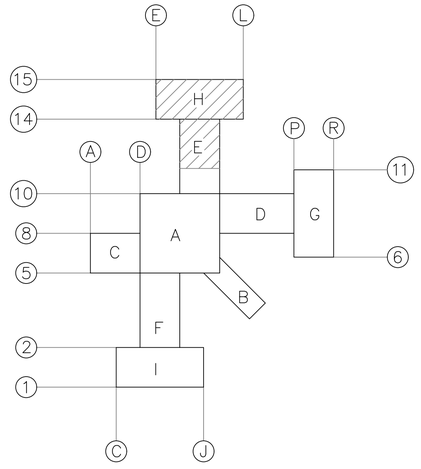

KEY PLAN PER METALLIC BLDG. CO.

SHEET NOTES:

1. 4" THICK CONCREETE SLAB-ON-GRADE OVER 6" OF FREE DRAINING 3/4" CRUSHED ROCK. CRUSHED ROCK SHALL CONTAIN NO FINES TO PROVIDE A CAPILLARY MOISTURE BREAK. REINFORCE SLAB WITH #4 BARS @ 18" O.C. BOTH WAYS AT SLAB MID-THICKNESS.
2. CONSTRUCTION JOINT PER 9a/S8.
2b. CONTROL JOINT PER 9b/S8.
3. GRADE BEAM 7/S8.
4. TIE BEAM
F. INDICATES FOOTING MARK. REFER TO FOOTING SCHEDULE 4/S8.

Precision Structural Engineering, Inc.
4810 B Shasta Way
Klamath Falls, Oregon 97603
Phone: (541) 850-6300
Fax: (541) 850-6233
www.structure1.com

Project:

KLAMATH TRIBES CENTRALIZED SOCIAL SERVICES AND ADMINISTRATION BUILDING

CHILOQUIN, OREGON

Architect:

JAMES MATTESON

Contractor:

BOGATAY CONSTRUCTION

Stamp:

PRELIMINARY NOT FOR BID OR CONSTRUCTION

REVISIONS:

MARK:	DATE:	DESCRIPTION / BY:

DRAWN BY: RYAN FARNSWORTH
DESIGNED BY: AB
CHECKED BY: NT
ISSUE DATE: 9-20-2001 "AS BUILT"
PROJECT NUMBER: 20-202

SHEET TITLE: FOUNDATION PLAN, BUILDING "E" & "H"

PAGE NO: S5 OF 8

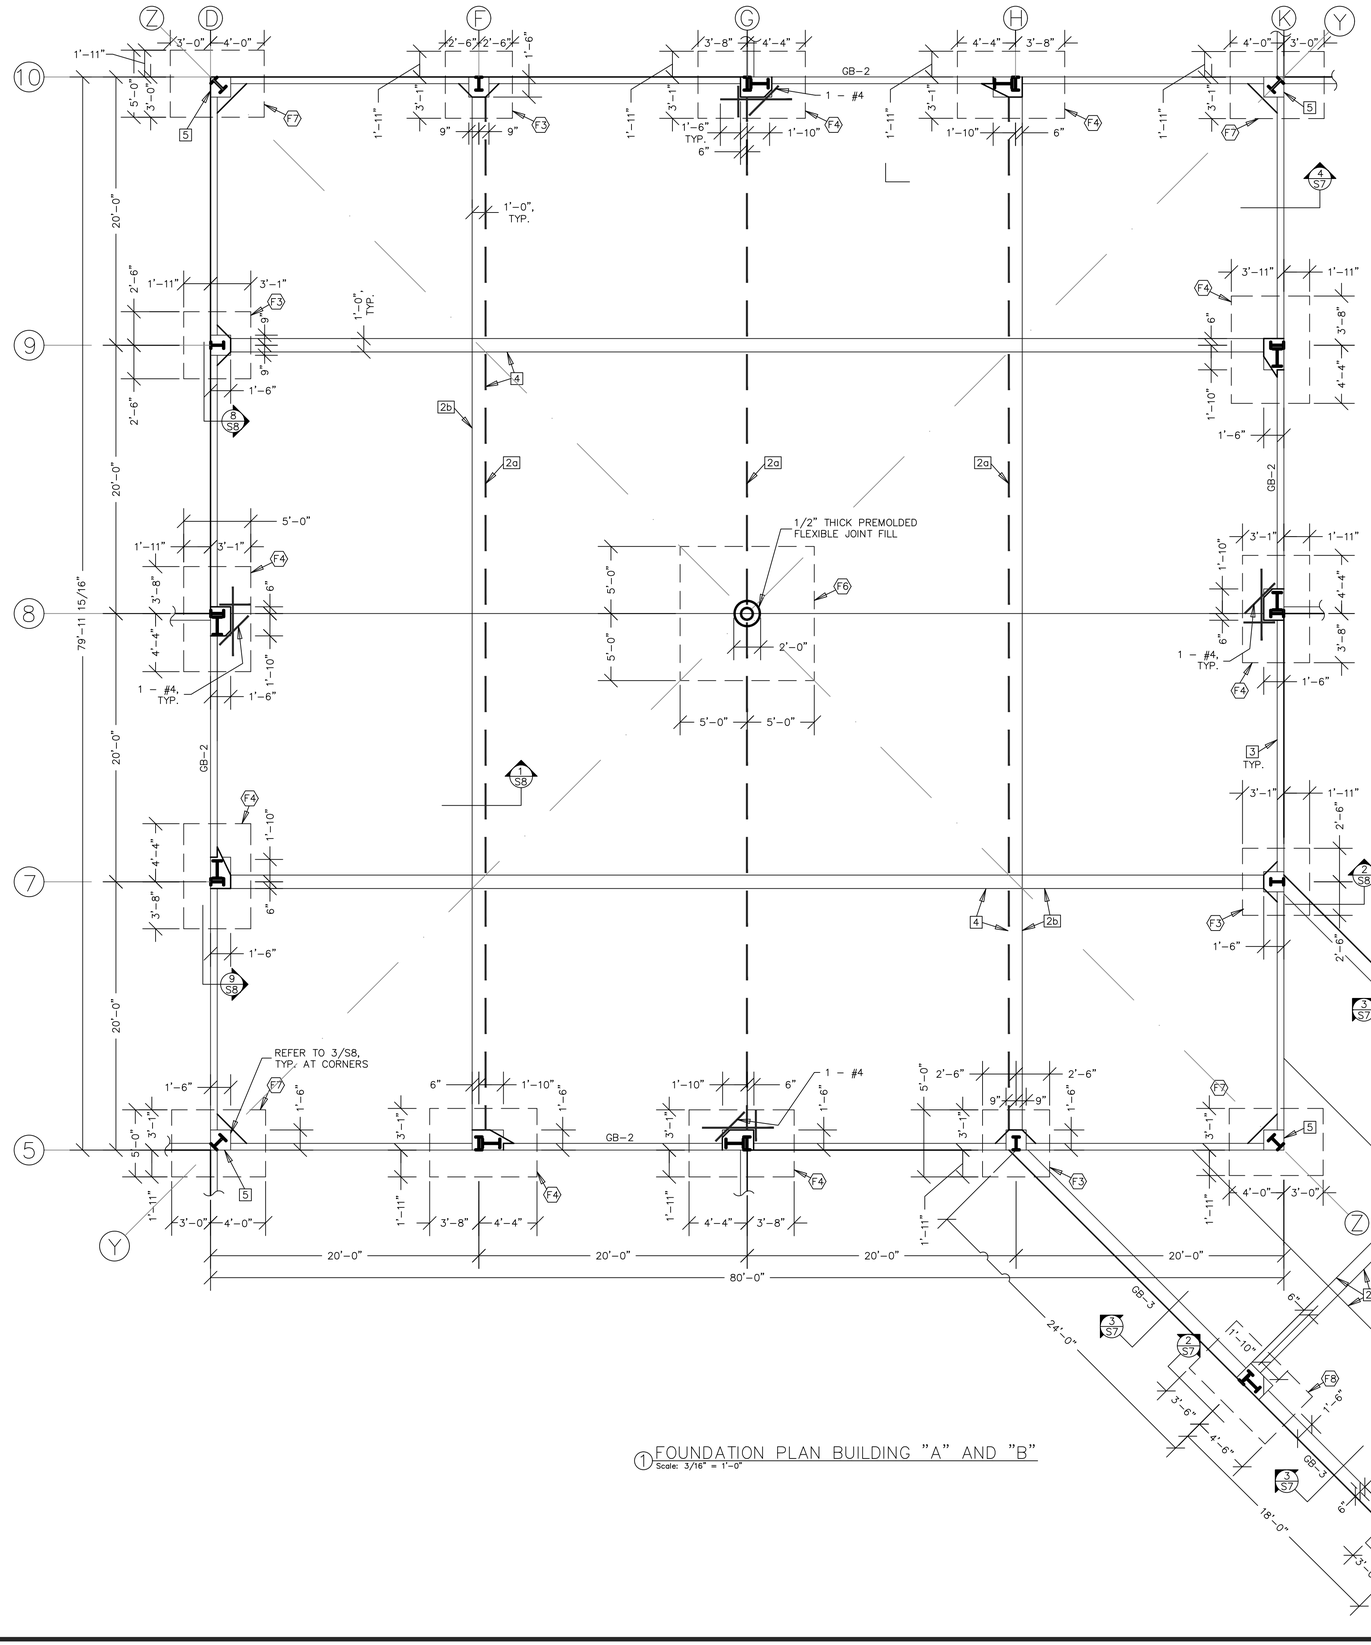

1 FOUNDATION PLAN BUILDING "A" AND "B"
Scale: 3/16" = 1'-0"

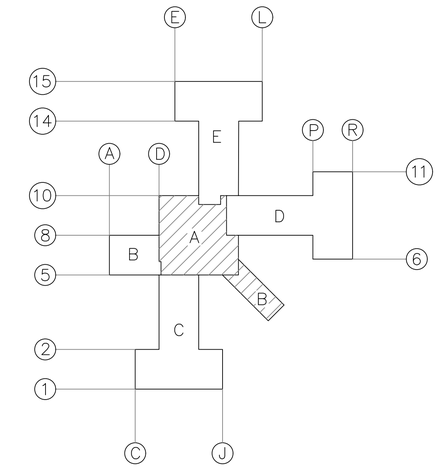

KEY PLAN PER ARCHITECT

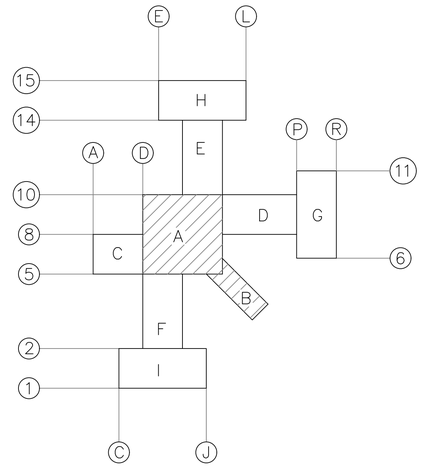

KEY PLAN PER METALLIC BLDG. CO.

Precision Structural Engineering, Inc.
4810 B Shasta Way
Klamath Falls, Oregon 97603
Phone: (541) 850-6300
Fax: (541) 850-6233
www.structure1.com

Project:

KLAMATH TRIBES CENTRALIZED SOCIAL SERVICES AND ADMINISTRATION BUILDING

CHILOQUIN, OREGON

Architect:

JAMES MATTESON

Contractor:

BOGATAY CONSTRUCTION

Stamp:

PRELIMINARY NOT FOR BID OR CONSTRUCTION

REVISIONS:

MARK:	DATE:	DESCRIPTION / BY:

SHEET NOTES:

1. 4" THICK CONCREETE SLAB-ON-GRADE OVER 6" OF FREE DRAINING 3/4" CRUSHED ROCK. CRUSHED ROCK SHALL CONTAIN NO FINES TO PROVIDE A CAPILLARY MOISTURE BREAK. REINFORCE SLAB WITH #4 BARS @ 18" O.C. BOTH WAYS AT SLAB MID-THICKNESS.
2. 2a ——— CONSTRUCTION JOINT PER 9a/S8.
3. 2b ——— CONTROL JOINT PER 9b/S8.
4. 3 GRADE BEAM 7/S8.
5. 4 TIE BEAM
6. 5 CORNER BARS SHALL LAP 4'-0" WITH GRADE BEAM STEEL. PROVIDE WELD PER 5/S8.
7. (F) INDICATES FOOTING MARK. REFER TO FOOTING SCHEDULE 4/S8.

DRAWN BY: RYAN FARNSWORTH
DESIGNED BY: AB
CHECKED BY: NT
ISSUE DATE: 9-20-2001 "AS BUILT"
PROJECT NUMBER: 20-202

SHEET TITLE: FOUNDATION PLAN, BUILDING "A" & "B"

PAGE NO: S6 OF 8

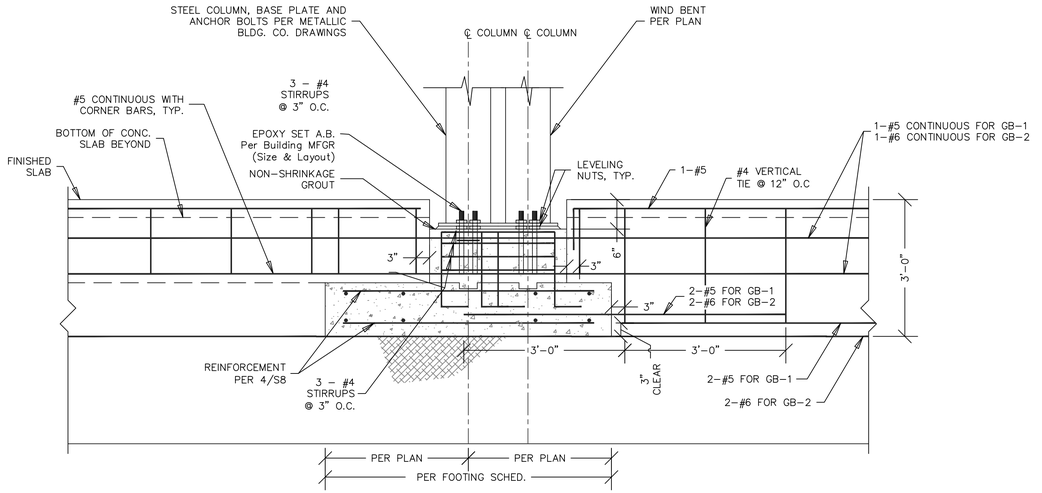

① TYPICAL GRADE BEAM FOOTING DETAILS AT WIND BENTS
Scale: 3/4" = 1'–0"

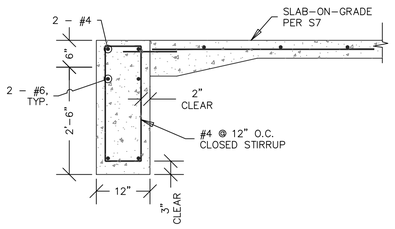

③ GRADE BEAM GB–3 DETAILS
Scale: 3/4" = 1'–0"

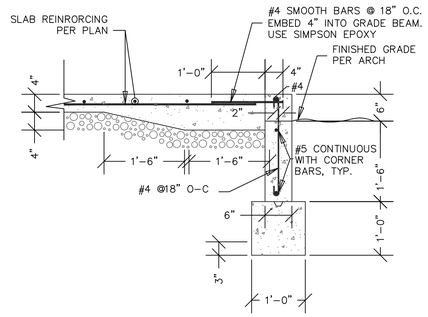

④ TYPICAL SLAB TO GRADE BEAM CONCRETE DETAIL
Scale: 3/4" = 1'–0"

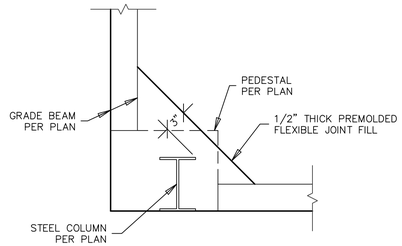

⑤ TYPICAL SLAB ISOLATION JOINTS AT FOOTING F5
Scale: 3/4" = 1'–0"

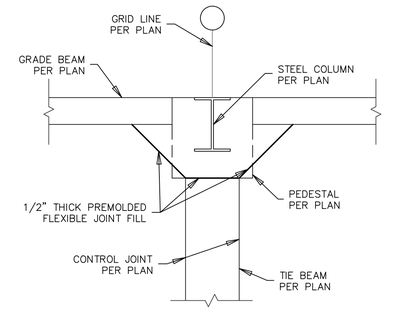

⑥ TYPICAL SLAB ISOLATION JOINTS AT FOOTING F1 & F3
Scale: 3/4" = 1'–0"

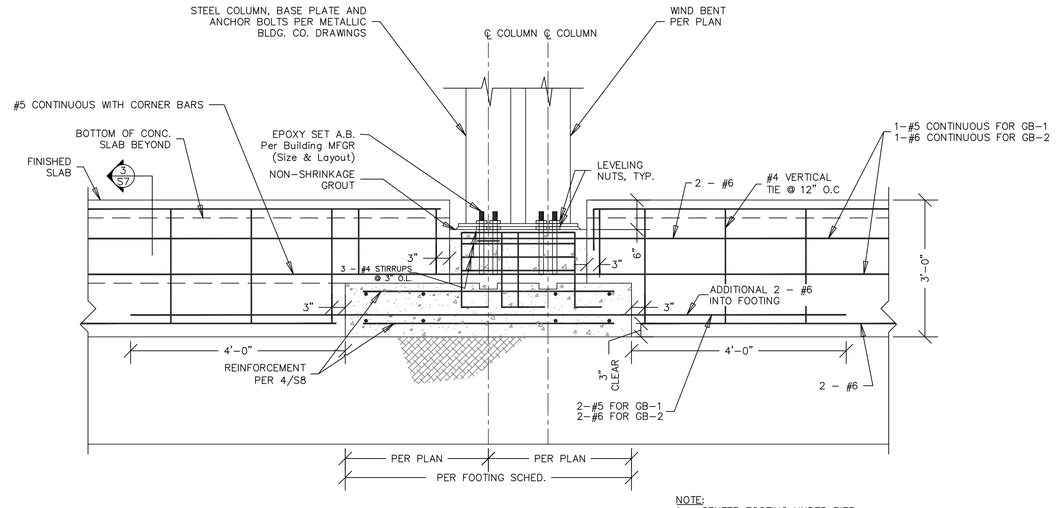

NOTE:
1 – CENTER FOOTING UNDER PIER.
2 – STRUCTURAL FILL/CRUSHED ROCK EXTEND 1'–6" BEYOND CONCRETE FOOTING AT ALL EDGES.

② GRADE BEAM AT GRID LINE 5–B FOOTING DETAILS
Scale: 3/4" = 1'–0"

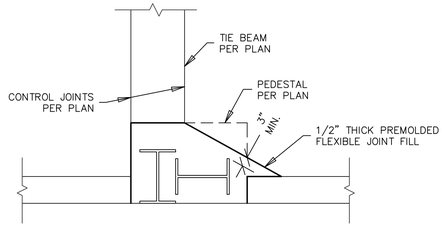

⑦ TYPICAL SLAB ISOLATION JOINTS AT FOOTING F2 & F4
Scale: 3/4" = 1'–0"

Precision Structural Engineering, Inc.
4810 B Shasta Way
Klamath Falls, Oregon 97603
Phone: (541) 850–6300
Fax: (541) 850–6233
www.structure1.com

Project:
KLAMATH TRIBES CENTRALIZED SOCIAL SERVICES AND ADMINISTRATION BUILDING

CHILOQUIN, OREGON

Architect:
JAMES MATTESON

Contractor:
BOGATAY CONSTRUCTION

Stamp:
PRELIMINARY NOT FOR BID OR CONSTRUCTION

REVISIONS:

MARK:	DATE:	DESCRIPTION / BY:

DRAWN BY: RYAN FARNSWORTH
DESIGNED BY: AB
CHECKED BY: NT
ISSUE DATE: 9–20–2001 "AS BUILT"
PROJECT NUMBER: 20–202

SHEET TITLE: FOUNDATION DETAILS

PAGE NO:
S7 OF 8

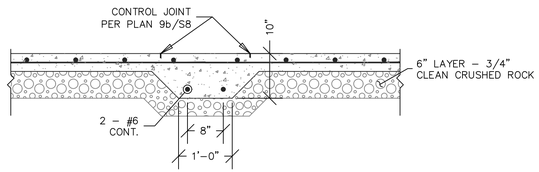

① FRAME TIE BEAM TYPICAL DETAILS
Scale: 3/4" = 1'–0"

MARK	DIMENSION			BOTTOM REINFORCMENT		PEDESTAL DIMENSION			REINFORCMENT		
	LENGTH "A"	WIDTH "B"	DEPTH "D"	LONGITUDINAL	TRANSVERSE	LENGTH "A"	WIDTH "B"	DEPTH "D"	VERTICAL	STIRRUPS	DETAIL NO./REMARKS
F1	6'–0"	5'–0"	1'–0"	5 – #5	6 – #5	1'–6"	1'–4"	1'–6"	8 – #5	3 – #4 @ 3" O.C. THEN #4 @ 6" O.C.	
F2	7'–0"	5'–0"	1'–0"	4 – #5 TOP 5 – #5 BOT	5 – #5 TOP 7 – #5 BOT	2'–2"	1'–6"	1'–6"	10 – #5		
F3	5'–0"	5'–0"	1'–0"	5 – #5	6 – #5	1'–6"	1'–6"	1'–6"	8 – #5		
F4	8'–0"	5'–0"	2'–0"	4 – #5 TOP 5 – #5 BOT	5 – #5 TOP 8 – #5 BOT	2'–4"	1'–6"	6"	10 – #5		
F5	6'–0"	5'–0"	1'–0"	5 – #5	6 – #5	1'–9"	1'–6"	1'–6"	8 – #5		
F6	10'–0"	10'–0"	1'–6"	8 – #5 TOP 8 – #7 BOT	8 – #5 TOP 8 – #7 BOT	1'–6"	1'–6"	1'–0"	10 – #5		
F7	7'–0"	5'–0"	1'–0"	5 – #5	7 – #5	1'–6"	1'–6"	1'–6"	8 – #5		
F8	8'–0"	5'–0"	1'–0"	5 – #5 TOP & BOT	8 – #5 TOP & BOT	2'–4"	1'–6"	1'–6"	8 – #5		

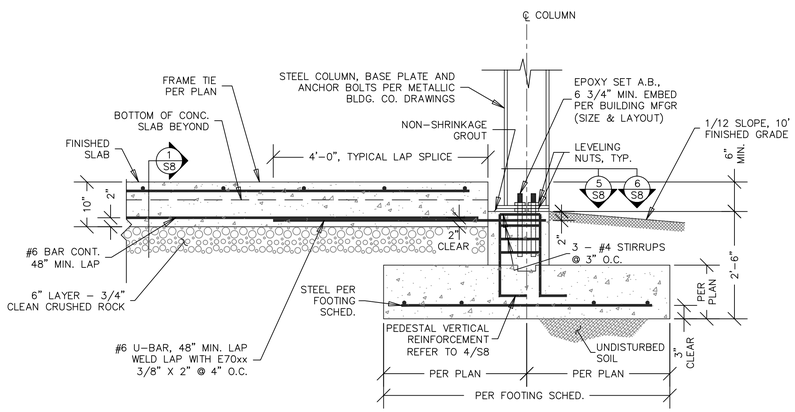

② TIE BEAM AND FOOTING TYPICAL DETAIL
Scale: 3/4" = 1'–0"

③ NOT USED
N.T.S.

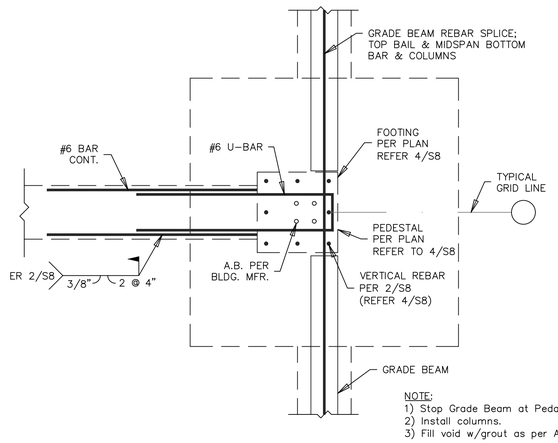

N.T.S.

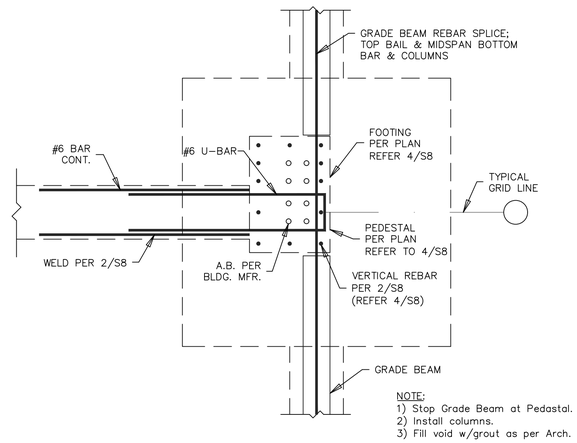

⑤ U BAR DETAILS
Scale: 3/4" = 1'–0"

⑥ U–BAR AT WIND BENT FRAME DETAILS
Scale: 3/4" = 1'–0"

⑦ NOT USED
N.T.S.

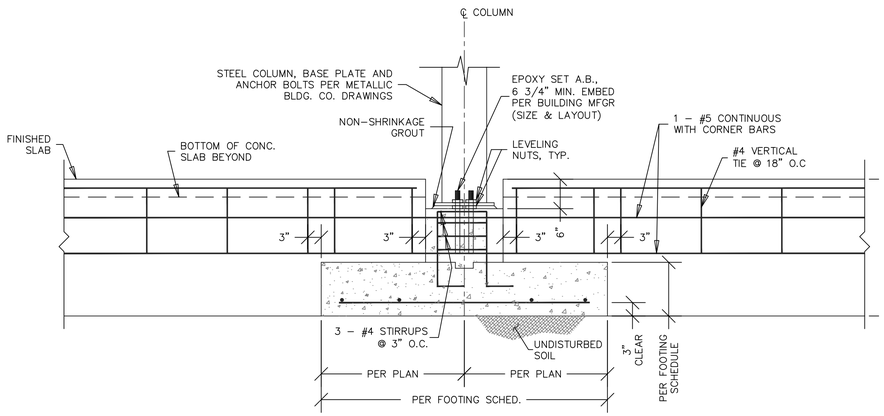

⑧ TYPICAL GRADE BEAM/FOOTING DETAILS
Scale: 3/4" = 1'–0"

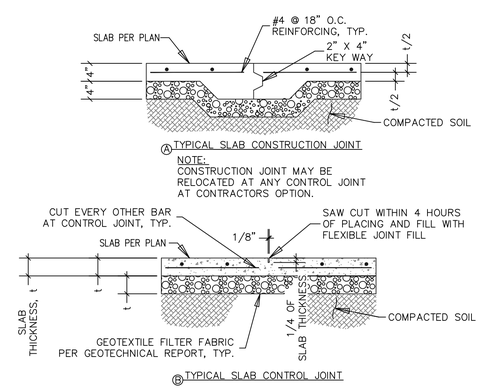

⑨ TYPICAL SLAB CONTRACTION JOINTS
Scale: 3/4" = 1'–0"

Precision Structural Engineering, Inc.
4810 B Shasta Way
Klamath Falls, Oregon 97603
Phone: (541) 850–6300
Fax: (541) 850–6233
www.structure1.com

Project:
KLAMATH TRIBES CENTRALIZED SOCIAL SERVICES AND ADMINISTRATION BUILDING
CHILOQUIN, OREGON

Architect:
JAMES MATTESON

Contractor:
BOGATAY CONSTRUCTION

Stamp:
PRELIMINARY NOT FOR BID OR CONSTRUCTION

REVISIONS:

MARK:	DATE:	DESCRIPTION / BY:

DRAWN BY: RYAN FARNSWORTH
DESIGNED BY: AB
CHECKED BY: NT
ISSUE DATE: 9–20–2001 "AS BUILT"
PROJECT NUMBER: 20–202

SHEET TITLE: FOUNDATION DETAILS

PAGE NO:
S8 OF 8

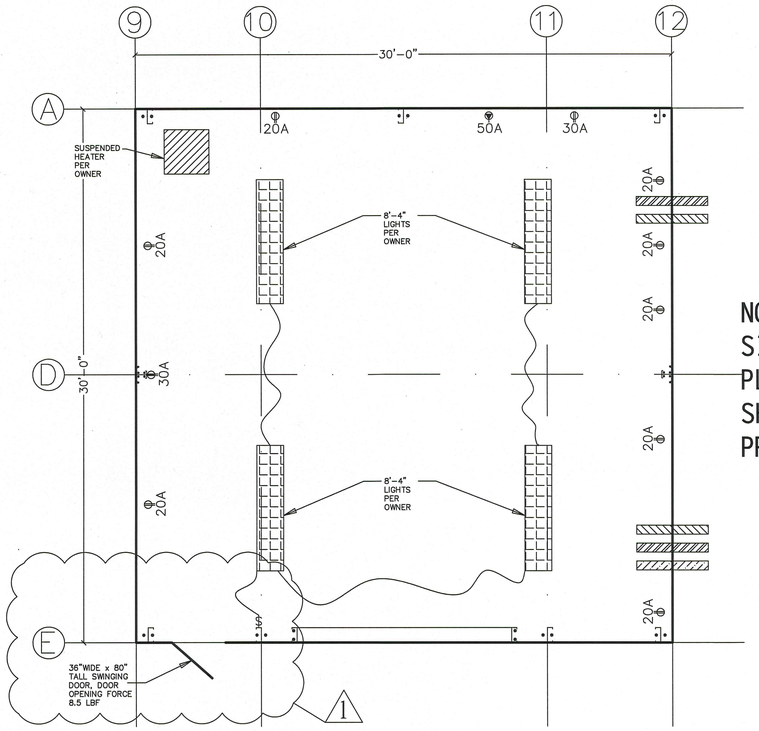

1 BUILDING #2 ELECTRICAL & PLUMBING PLAN
SCALE: 1/4" = 1'-0"

NOTE:
SIZE AND LOCATION OF ELECTRICAL AND PLUMBING ITEMS ARE APPROXIMATE AND SHOULD BE APPROVED BY THE OWNER PRIOR TO FINAL INSTALLATION.

NOTE:
OWNER TO CONFIRM WITH BUILDING MANUFACTURER THAT INCIDENTAL LOADING FROM ATTACHED ITEMS SUCH AS LIGHTING, HEATERS, ETC. DO NOT EXCEED THE BUILDING DESIGN

LEGEND:

- 2" CAPPED ELECTRICAL CONDUIT
- CAPPED WATER LINE
- CAPPED SEWER LINE
- 120V DUPLEX RECEPTACLE
- 240V RECEPTACLE
- SWITCH

Precision Structural Engineering, Inc.

www.structure1.com
Klamath Falls Office
250 Main
Klamath Falls, Oregon 97601
Phone: (541) 850-6300
Fax: (541) 850-6233
info@structure1.com

Medford Office
836 Mason Way
Medford OR. 97501
Phone: (541) 858-8500
Fax: (541) 776-4663
infomd@structure1.com

Licensed in:
Anzona, California, Colorado, Florida, Hawaii, Idaho, Iowa, Kansas, Missouri, Montana, Nebraska, Nevada, Oregon, Pennsylvania, Utah, Virginia, Washington, Wyoming

Construction Types:
Light Gauge Steel, Straw Bales, Bamboo, Log, Timber/Wood, Structural Insulated Panels/SIPs, Masonry, Steel, Concrete, Modular Homes/Factory Built Housing (FBH), Coffee Shop, ICF etc. Commercial or Residential.

Project:
Klamath Tribes, Chiloquin
501 South Chiloquin Blvd., Chiloquin, OR

Client:
Klamath Tribes

6-29-17

Stamp:
STRUCTURAL ENGINEER
OREGON
OCT. 15, 1991
NABIL M. TAHA
EXPIRATION DATE: 06/30/18

REVISIONS:

MARK:	DATE:	BY:
1	6-29-17	BH

DRAWN BY: M.R.D
DS. BY: M.R.D
CHK BY: N.T.
DATE:05-30-17
PROJECT #: Tribes 216-1
TITLE: BUILDING #2 ELECT. & PLUMB.
PAGE NO: E&P1

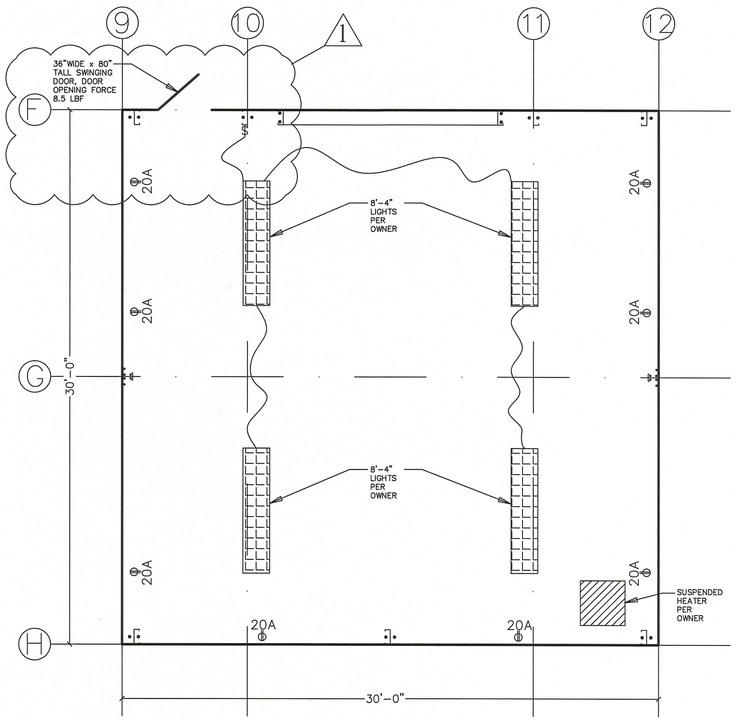

1 BUILDING #3 ELECTRICAL & PLUMBING PLAN
SCALE: 1/4" = 1'-0"

NOTE:
SIZE AND LOCATION OF ELECTRICAL AND PLUMBING ITEMS ARE APPROXIMATE AND SHOULD BE APPROVED BY THE OWNER PRIOR TO FINAL INSTALLATION.

LEGEND:

- 2" CAPPED ELECTRICAL CONDUIT
- CAPPED WATER LINE
- CAPPED SEWER LINE
- 120V DUPLEX RECEPTACLE
- 240V RECEPTACLE
- SWITCH

NOTE:
OWNER TO CONFIRM WITH BUILDING MANUFACTURER THAT INCIDENTAL LOADING FROM ATTACHED ITEMS SUCH AS LIGHTING, HEATERS, ETC. DO NOT EXCEED THE BUILDING DESIGN

Precision Structural Engineering, Inc.
www.structure1.com
Klamath Falls Office
250 Main
Klamath Falls, Oregon 97601
Phone: (541) 850-6300
Fax: (541) 850-6233
info@structure1.com

Medford Office
836 Mason Way
Medford OR. 97501
Phone: (541) 858-8500
Fax: (541) 776-4663
infomd@structure1.com

Licensed in:
Arizona, California, Colorado, Florida, Hawaii, Idaho, Iowa, Kansas, Missouri, Montana, Nebraska, Nevada, Oregon, Pennsylvania, Utah, Virginia, Washington, Wyoming

Construction Types:
Light Gauge Steel, Straw Bales, Bamboo, Log, Timber/Wood, Structural Insulated Panels/SIPs, Masonry, Steel, Concrete, Modular Homes/Factory Built Housing (FBH), Coffee Shop, ICF etc. Commercial or Residential.

Project:
Klamath Tribes, Chiloquin
501 South Chiloquin Blvd., Chiloquin, OR

Client:
Klamath Tribes

Stamp: 6-29-17
STRUCTURAL REGISTERED PROFESSIONAL ENGINEER
OREGON
JULY 15, 1994
NABIL M. TAHA
EXPIRATION DATE: 06/30/18

REVISIONS:

MARK	DATE:	BY:
1	6-29-17	BH

DRAWN BY: M.R.D
DS. BY: M.R.D
CHK BY: N.T.
DATE:05-30-17
PROJECT #:
Tribes 216-1
TITLE:
BUILDING #3 ELECT. & PLUMB.
PAGE NO:
E&P2